



# TLOCRT PRIZEMLJA MJ.1:100

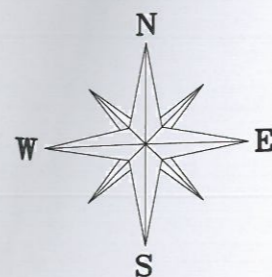

## PRIZEMLJE




Z	NAZIV PROSTORIJE	NETTO	KOEFIC.	OBR.NETTO
1	ulazno stepenište	1.64 m <sup>2</sup>	0.50	0.82 m <sup>2</sup>
2	hodnik	6.91 m <sup>2</sup>	0.25	0.86 m <sup>2</sup>
3	stepenište	6.45 m <sup>2</sup>	1.00	6.45 m <sup>2</sup>
4	wc	1.22 m <sup>2</sup>	1.00	1.22 m <sup>2</sup>
		19.64 m <sup>2</sup>		16.26 m <sup>2</sup>

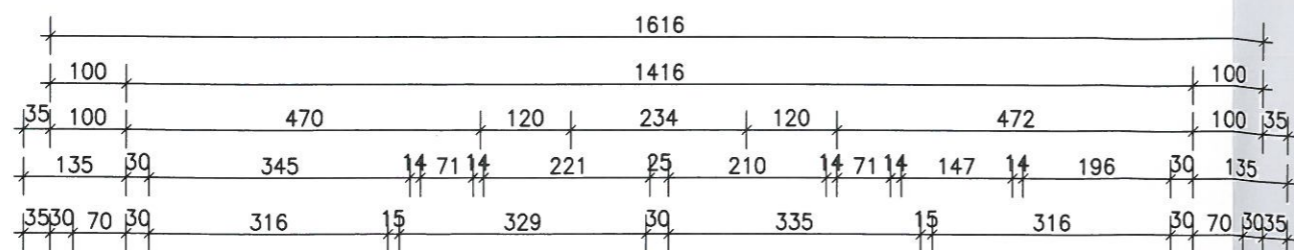

S4	NAZIV PROSTORIJE	NETTO	KOEFIC.	OBR.NETTO
4	d.boravak i blagovao.	22.69 m <sup>2</sup>	1.00	22.69 m <sup>2</sup>
5	s.soba	8.90 m <sup>2</sup>	1.00	8.90 m <sup>2</sup>
6	terasa	5.29 m <sup>2</sup>	0.50	2.65 m <sup>2</sup>
7	hodnik	4.90 m <sup>2</sup>	1.00	4.90 m <sup>2</sup>
8	kupaonica	5.85 m <sup>2</sup>	1.00	5.85 m <sup>2</sup>
9	kuhinja	6.90 m <sup>2</sup>	1.00	6.90 m <sup>2</sup>
10	s.soba	8.85 m <sup>2</sup>	1.00	8.85 m <sup>2</sup>
11	terasa	4.20 m <sup>2</sup>	0.50	2.10 m <sup>2</sup>
12	s.soba	9.04 m <sup>2</sup>	1.00	9.04 m <sup>2</sup>
		76.62 m <sup>2</sup>		71.88 m <sup>2</sup>

S5	NAZIV PROSTORIJE	NETTO	KOEFIC.	OBR.NETTO
13	hodnik	9.54 m <sup>2</sup>	1.00	9.54 m <sup>2</sup>
14	s.soba	14.77 m <sup>2</sup>	1.00	14.77 m <sup>2</sup>
15	terasa	4.99 m <sup>2</sup>	0.50	2.50 m <sup>2</sup>
16	kuhinja i blagovaona	11.58 m <sup>2</sup>	1.00	11.58 m <sup>2</sup>
17	kupaonica	6.12 m <sup>2</sup>	1.00	6.12 m <sup>2</sup>
18	s.soba	8.88 m <sup>2</sup>	1.00	8.88 m <sup>2</sup>
19	s.soba	8.85 m <sup>2</sup>	1.00	8.85 m <sup>2</sup>
20	terasa	4.20 m <sup>2</sup>	0.50	2.10 m <sup>2</sup>
		68.93 m <sup>2</sup>		64.34 m <sup>2</sup>

PRIZEMLJE UKUPNO:		
NETO:		165.19 m <sup>2</sup>
NETO KORISNO:		152.48 m <sup>2</sup>

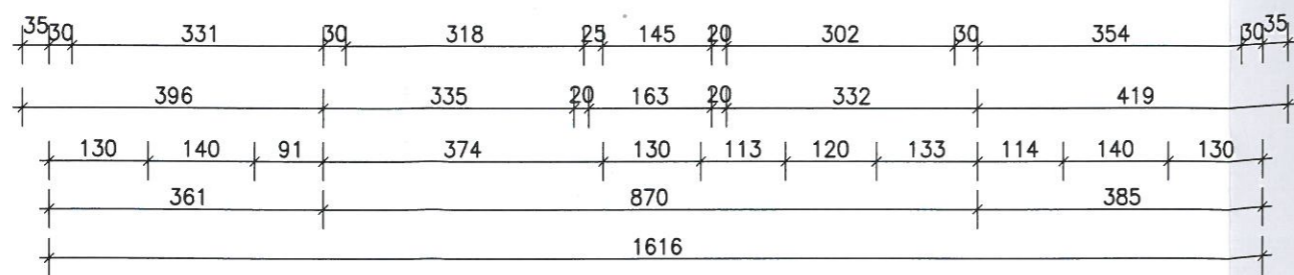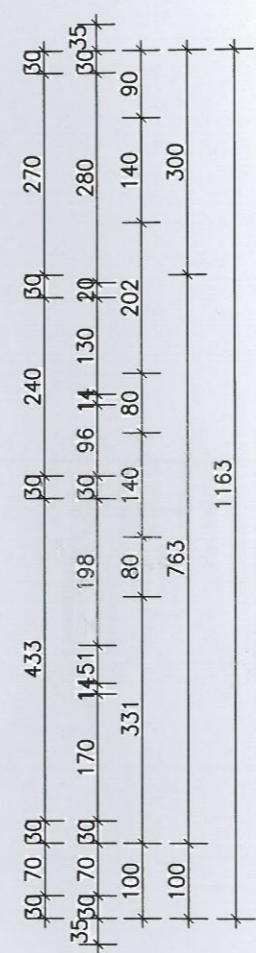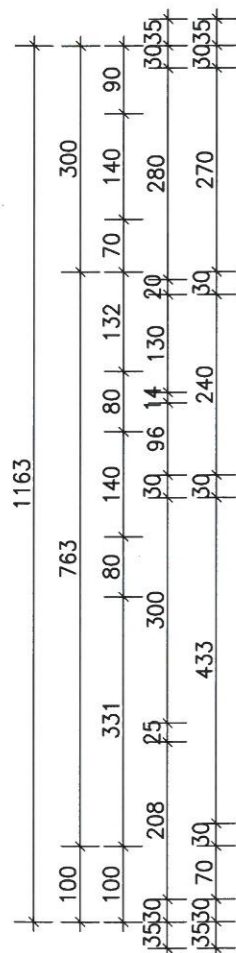

PODNOŠITELJ	MARJANOVIĆ ANTE		
ZAHTEVA :	Đuba br. 22G , Umag		
GRAĐEVINA :	VIŠESTAMBENA ZGRADA S+P+2+PK		
LOKACIJA :	Umag , Naselje Đuba k.č.br. 3793/11 k.o. Umag		
FAZA PROJEKTA :	SNIMKA IZVEDENOG STANJA		
VRSTA PROJEKTA :	ARHITEKTONSKA SNIMKA		
NACRT :	IZVEDENO STANJE TLOCRT PRIZEMLJA		
IZRADILA :	LJILJANA PERŠIĆ , dipl.ing.arh. <i>Peršić</i>		
SURADNIK :	UNA MUFTIĆ , mag.ing.aedif. <i>Muftić</i>		
DIREKTOR :	ZLATKO MUFTIĆ , dipl.ing.grad. <i>Muftić</i>		
BROJ :	DATUM :	MJERILO :	NACRT br. :
L-35/13-A	prosinac 2013	1:100	3

## IZVEDENO STANJE

HRVATSKA KOMORA INŽENJERA GRAĐEVINARSTVA  
**Zlatko Muftić**  
 dipl.ing.grad.  
 Ovlašteni inženjer građevinarstva

**LJILJANA PERŠIĆ**  
 dipl.ing.arh.  
 OVLAŠTENA ARHITEKTICA  
 A 3109