
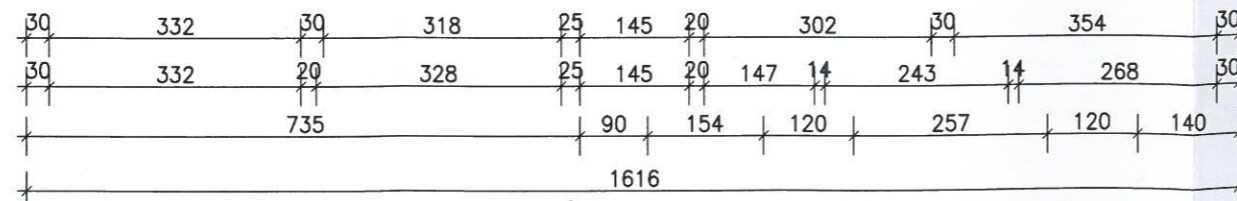
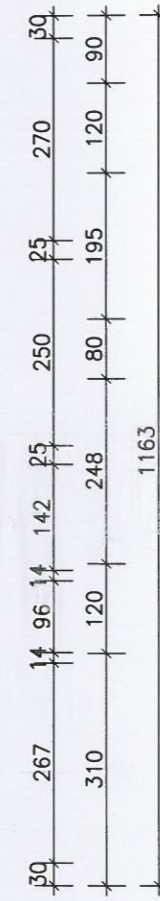
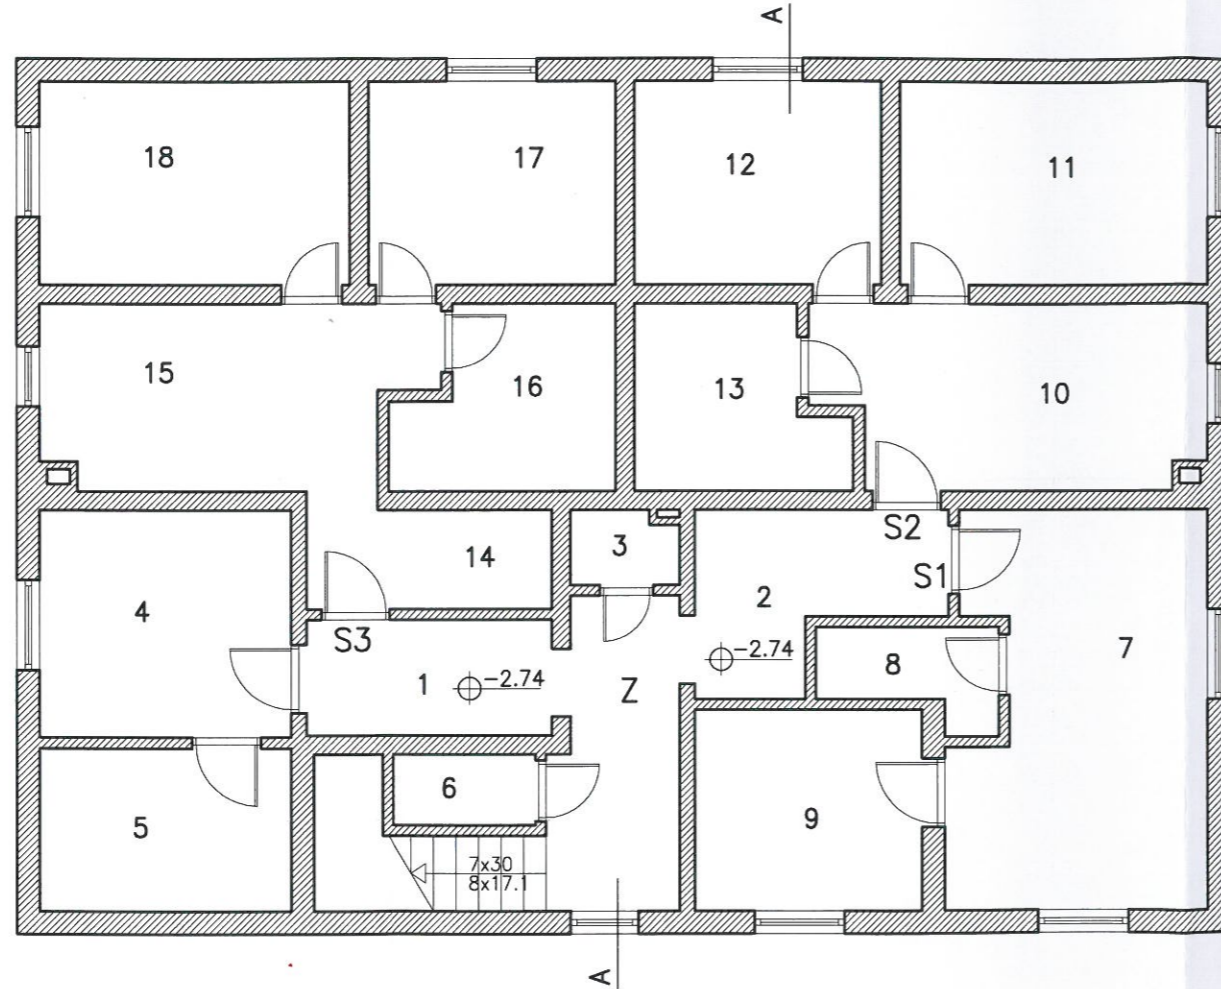
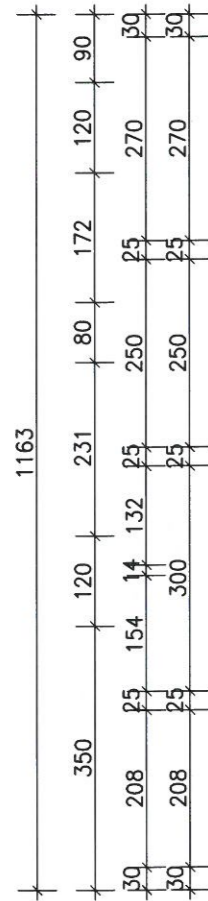
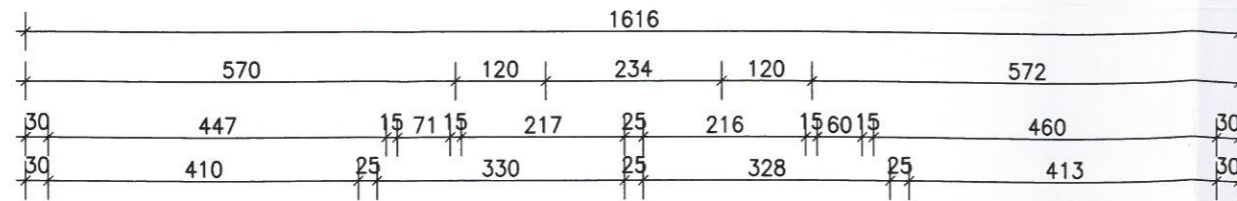


# TLOCRT SUTERENA MJ.1:100

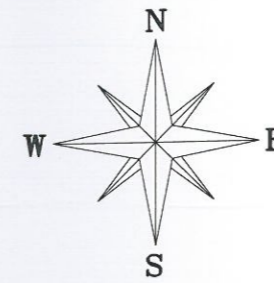

## SUTEREN

Z	NAZIV PROSTORIJE	NETTO	KOEFIC.	OBR.NETTO
1	hodnik	12.18 m <sup>2</sup>	1.00	12.18 m <sup>2</sup>
2	hodnik	6.53 m <sup>2</sup>	1.00	6.53 m <sup>2</sup>
3	wc	1.22 m <sup>2</sup>	1.00	1.22 m <sup>2</sup>
4	spremište	10.02 m <sup>2</sup>	1.00	10.02 m <sup>2</sup>
5	spremište	7.17 m <sup>2</sup>	1.00	7.17 m <sup>2</sup>
6	spremište	1.63 m <sup>2</sup>	1.00	1.63 m <sup>2</sup>
		38.75 m <sup>2</sup>		38.75 m <sup>2</sup>

S1	NAZIV PROSTORIJE	NETTO	KOEFIC.	OBR.NETTO
7	kuhinja i blagovaona	17.17 m <sup>2</sup>	1.00	17.17 m <sup>2</sup>
8	kupaonica	2.69 m <sup>2</sup>	1.00	2.69 m <sup>2</sup>
9	s.soba	8.06 m <sup>2</sup>	1.00	8.06 m <sup>2</sup>
		27.92 m <sup>2</sup>		27.92 m <sup>2</sup>

S2	NAZIV PROSTORIJE	NETTO	KOEFIC.	OBR.NETTO
10	kuhinja i blagovaona	12.32 m <sup>2</sup>	1.00	12.32 m <sup>2</sup>
11	s.soba	11.15 m <sup>2</sup>	1.00	11.15 m <sup>2</sup>
12	s.soba	8.53 m <sup>2</sup>	1.00	8.53 m <sup>2</sup>
13	kupaonica	6.14 m <sup>2</sup>	1.00	6.14 m <sup>2</sup>
		38.14 m <sup>2</sup>		38.14 m <sup>2</sup>

S3	NAZIV PROSTORIJE	NETTO	KOEFIC.	OBR.NETTO
14	hodnik	4.57 m <sup>2</sup>	1.00	4.57 m <sup>2</sup>
15	kuhinja i blagovaona	11.96 m <sup>2</sup>	1.00	11.96 m <sup>2</sup>
16	kupaonica	6.46 m <sup>2</sup>	1.00	6.46 m <sup>2</sup>
17	s.soba	8.58 m <sup>2</sup>	1.00	8.58 m <sup>2</sup>
18	s.soba	11.07 m <sup>2</sup>	1.00	11.07 m <sup>2</sup>
		42.64 m <sup>2</sup>		42.64 m <sup>2</sup>

SUTEREN UKUPNO:			
NETO:			147.45 m <sup>2</sup>
NETO KORISNO:			147.45 m <sup>2</sup>



PODNOŠITELJ	MARJANOVIĆ ANTE		
ZAHITJEVA :	Đuba br. 22G , Umag		
GRAĐEVINA :	VIŠESTAMBENA ZGRADA S+P+2+Pk		
LOKACIJA :	Umag , Naselje Đuba k.č.br. 3793/11 k.o. Umag		
FAZA PROJEKTA :	SNIMKA IZVEDENOG STANJA		
VRSTA PROJEKTA :	ARHITEKTONSKA SNIMKA		
NACRT :	IZVEDENO STANJE TLOCRT SUTERENA		
IZRADILA :	LJILJANA PERŠIĆ , dipl.ing.arh.	<i>Peršić</i>	
SURADNIK :	UNA MUFTIĆ , mag.ing.aedif.	<i>Muftić</i>	
DIREKTOR :	ZLATKO MUFTIĆ , dipl.ing.grad.	<i>Muftić</i>	
BROJ :	DATUM :	MJERILO :	NACRT br. :
L-35/13-A	prosinac 2013	1:100	2

## IZVEDENO STANJE

HRVATSKA KOMORA INŽENJERA GRAĐEVINARSTVA  
**Zlatko Muftić**  
 dipl. ing. građ.  
 Ovlašteni inženjer građevinarstva  
 G 1460

**LJILJANA PERŠIĆ**  
 dipl.ing.arh.  
 OVLAŠTENA ARHITEKTICA  
 A 3109